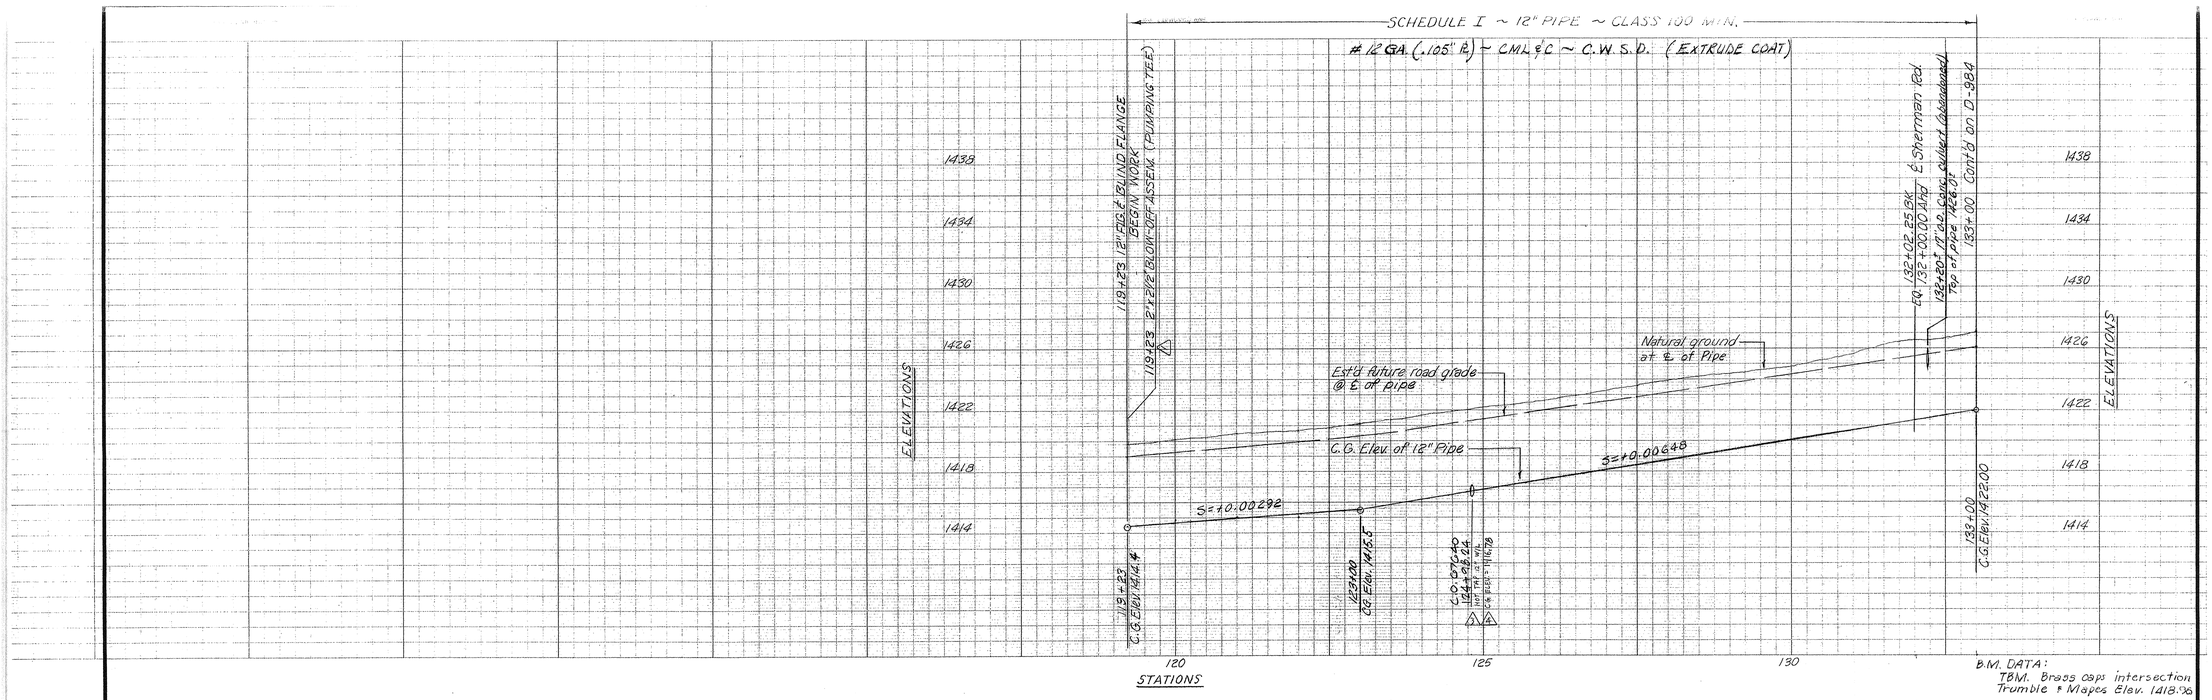

B.M. DATA:
TBM. Brass caps intersection Trumble & Mapes Elev. 1418.98

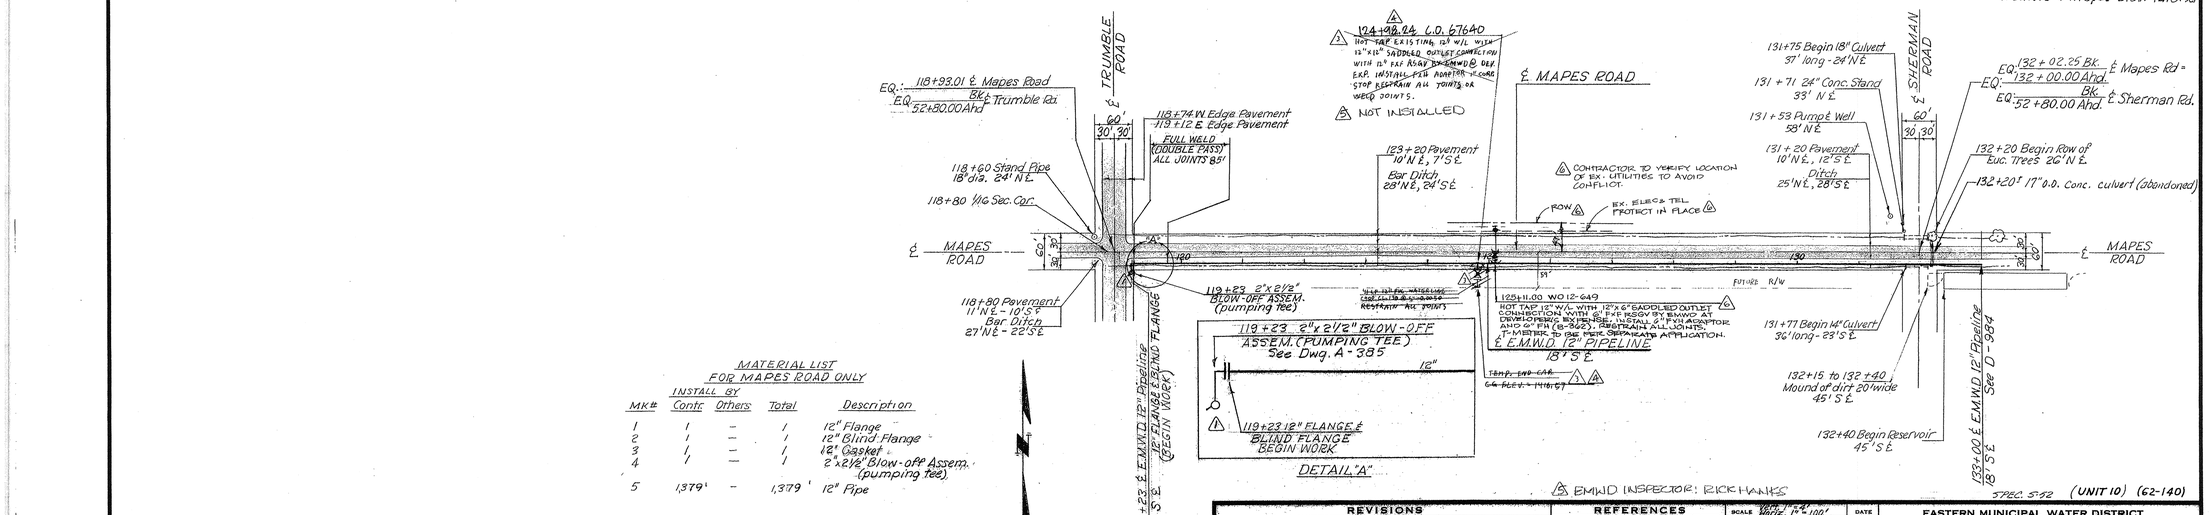

MATERIAL LIST
FOR MAPES ROAD ONLY

MK#	INSTALL BY Contr.	Others	Total	Description
1	1	–	1	12" Flange
2	1	–	1	12" Blind Flange
3	1	–	1	12" Gasket
4	1	–	1	2"x2½" Blow-off Assem. (pumping tee)
5	1,379'	–	1,379'	12" Pipe

SPEC. 5-52 (UNIT 10) (62-140)

REVISIONS					REFERENCES			
NO.	DATE	INITIAL	DESCRIPTION	APP'VD	T-1.D.13, Unit 10-1, pg. 9 & 11	SCALE	Vert. 1" = 5' Horiz. 1" = 100'	DATE
1	9/1/63	BG	Changed location of Blow-off	LAH	L-1.D.13, Unit 10-1, pg. 21 & 22	DESIGNED		
2	2/10/64	RKM	As constructed		Ramona Farms No. 6 & 14	DRAWN	B.G.	2/21/63
3	9/30/07	MPS	ADDED 12" HOT TAP 12" FIG. TEMP. END CAP C.O. 67640			TRACED		
4	8/3/07	L.A.M.	ADDED HOT TAP PER 125+22.08 TO 124+98.24	SMM 9/3/07		CHECKED	JAS	RAH 3/26/63
5	10/23/08	PW	AS CONST CO 67640/41 (C.E. 6/18/08)				W.B.P.	
6	10/7/09	JBH	ADDED HOT TAP & FH (WO 12-649)	SMM 10/7/09		RECOMMENDED		

EASTERN MUNICIPAL WATER DISTRICT
RIVERSIDE COUNTY, CALIFORNIA

IMPROVEMENT DISTRICT NO. 13 & A

MAPES ROAD ~ Sta. 119+23 to 133+00
PLAN & PROFILE ~ TRUMBLE to SHERMAN RD.

APPROVED — GENERAL MANAGER & CHIEF ENGINEER

NO. D-983

COORD. 19-T

AS CONSTRUCTED