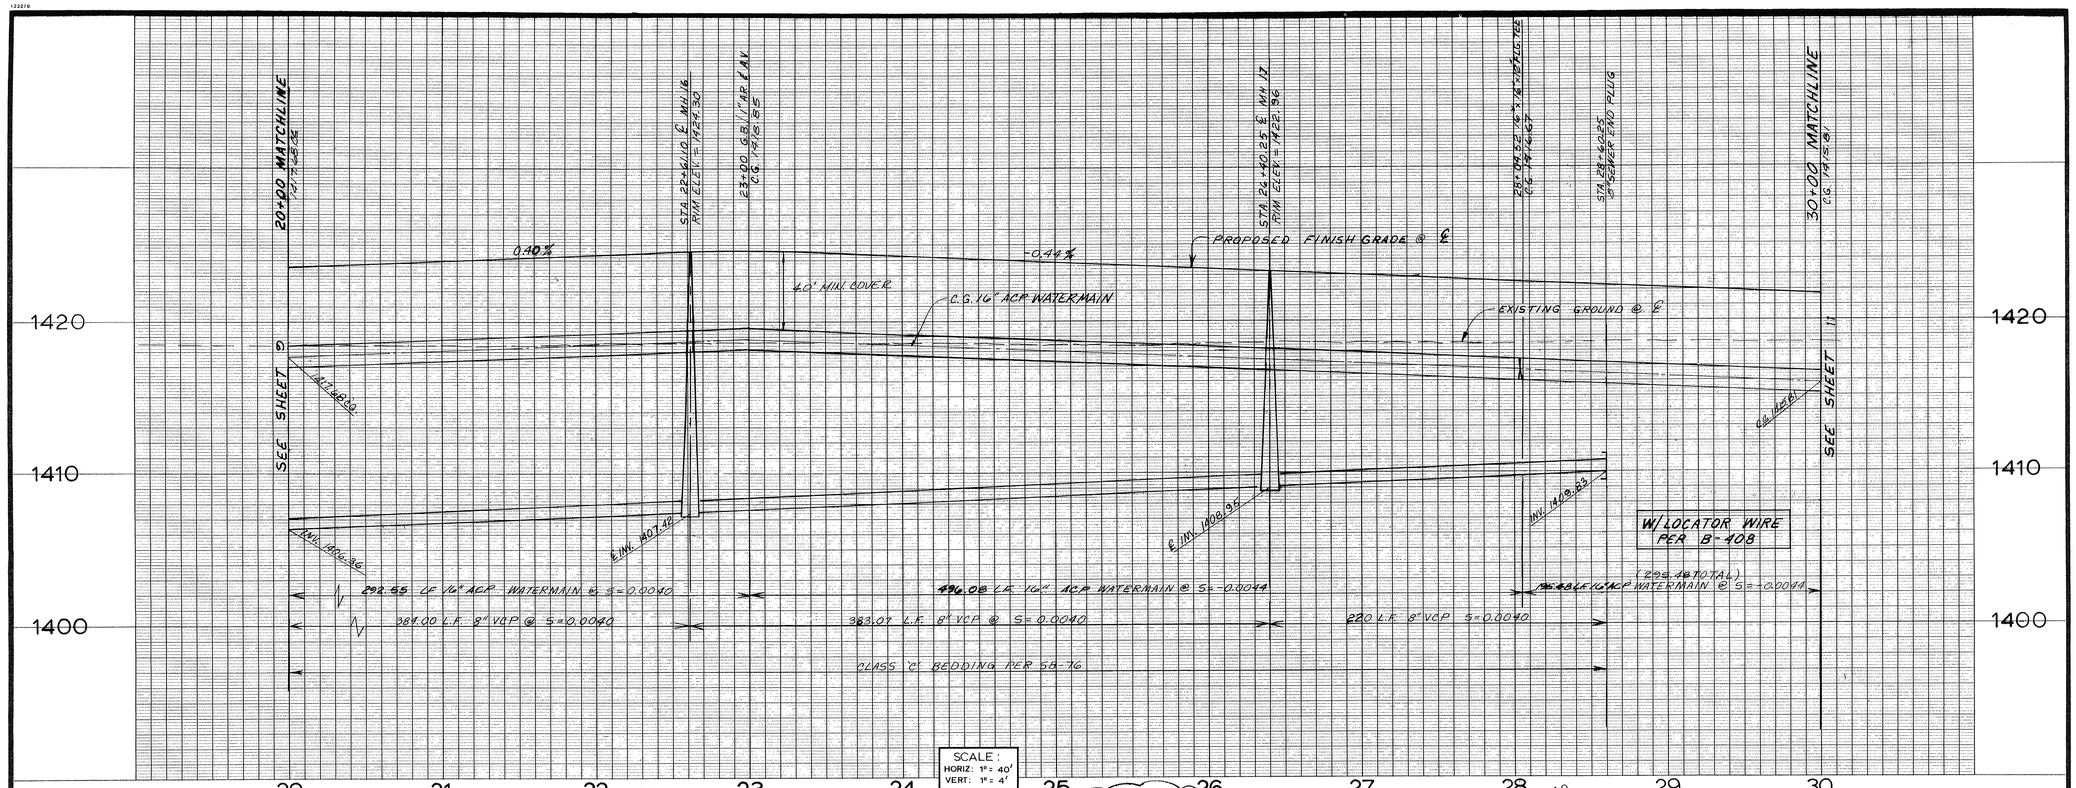

CO# 46140 SEWER SPEC 490 S
CO# 45610 WATER SPEC 491 W

DIGALERT
DIAL TOLL FREE
1-800-422-4133
AT LEAST TWO DAYS BEFORE YOU DIG
UNDERGROUND SERVICE ALERT OF SOUTHERN CALIFORNIA

WATER/SEWER APPROVED BY:
EASTERN MUNICIPAL WATER DISTRICT
DIRECTOR OF ENGINEERING — DATE 8/10/90

APPROVALS	INITIAL	DATE		INITIAL	DATE
PROJ. ENG.	BR	8/8/90	SEWER OPER.		
PLANNING			CONSTRUCTION		8/9/90
WATER OPER.			DESIGN	TW	8/13/90

REVISIONS:
2 ADDED HOT TAP & MANIFOLD AND 6" SWR. LAT. PER WO 12-649 SMM 10/07/09
1 ADDED F.H.'S & NEW PARKING ENTRANCE 10/9/96
0 AS CONSTRUCTED PER C.O. 46610/46140 JJ 5/31/93

DESIGNED BY:
CHECKED BY:
DRAWN BY:
REGIONAL MANAGER:

APPROVED BY: Michael Sylcowicz
DATE: 4-24-90
REGISTERED CIVIL ENGINEER NO. 26406
APPROVED BY: CITY OF PERRIS
DATE:

NBS/LOWRY
ENGINEERS & PLANNERS
P.O. BOX 851 HEMET, CA. 92343 (714) 658-7116

SCALE: HORIZ. 1"=40' VERT. 1"=4'
DATE APRIL '90
BENCH MARK: SEE SHEET 1

CITY OF PERRIS
EMWD OPERATIONS & ADMIN. CENTER
SANITARY SEWER & WATER PLAN & PROFILE
TRUMBLE ROAD
W.O. H65-257.329 F.B.

SERV. AREA 41 & 35
W.O. 86-323
C.O. SEE ABOVE
COORD. 18-7
SHT. 10 of 17
D- 12652
SD- 1737
FILE NO.- PU-4-16264